




FRONT VIEW

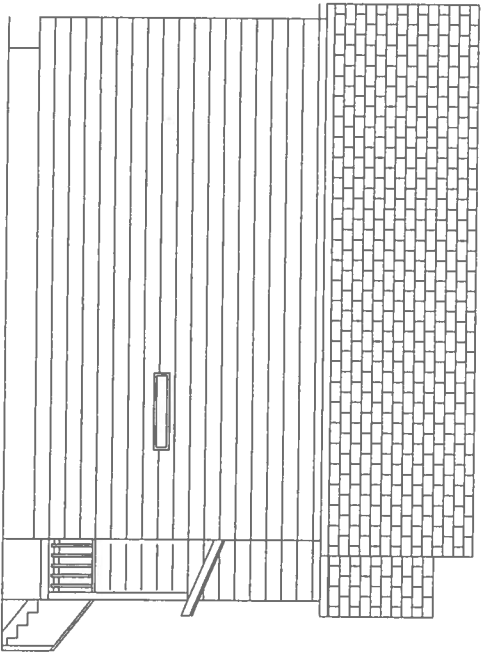

LEFT VIEW

ELEVATION VIEWS

SCALE: 1/8" = 1'
 34X38F01.DWG
 (12/07/21)


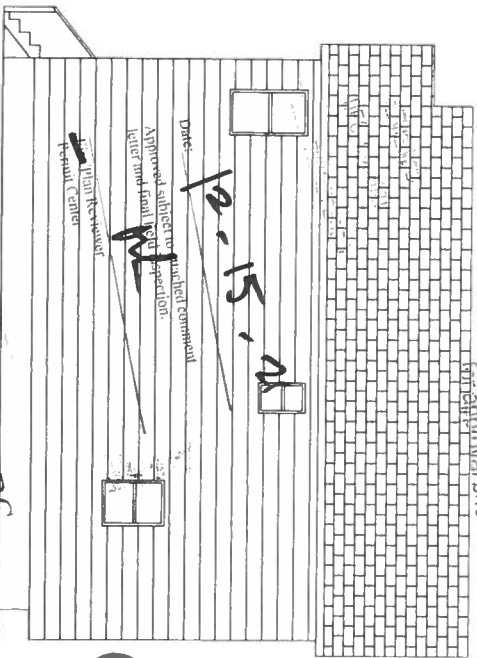
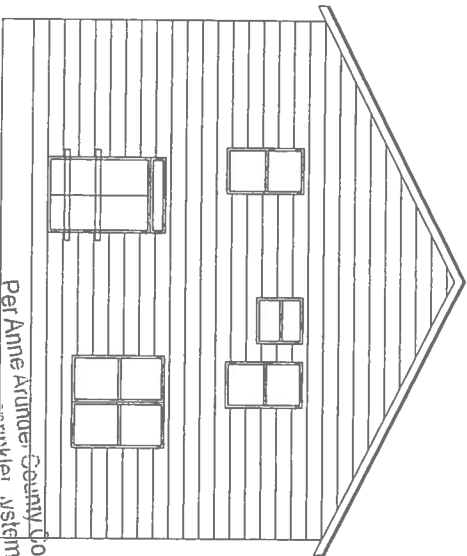



Per Anne Arundel County Code,
 automatic sprinkler system, per
 NFPA 13D, shall be provided.
 Submit Sprinkler Shop Drawings
 for approval only

Date: 12-15-21
 Approved subject to Building Department
 letter and final legal description.
 Plan Reviewed
 Permit Center


RIGHT VIEW 2018 IRC


INSP
BO2402998

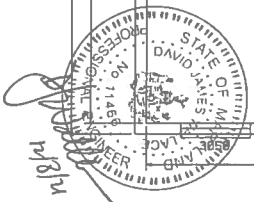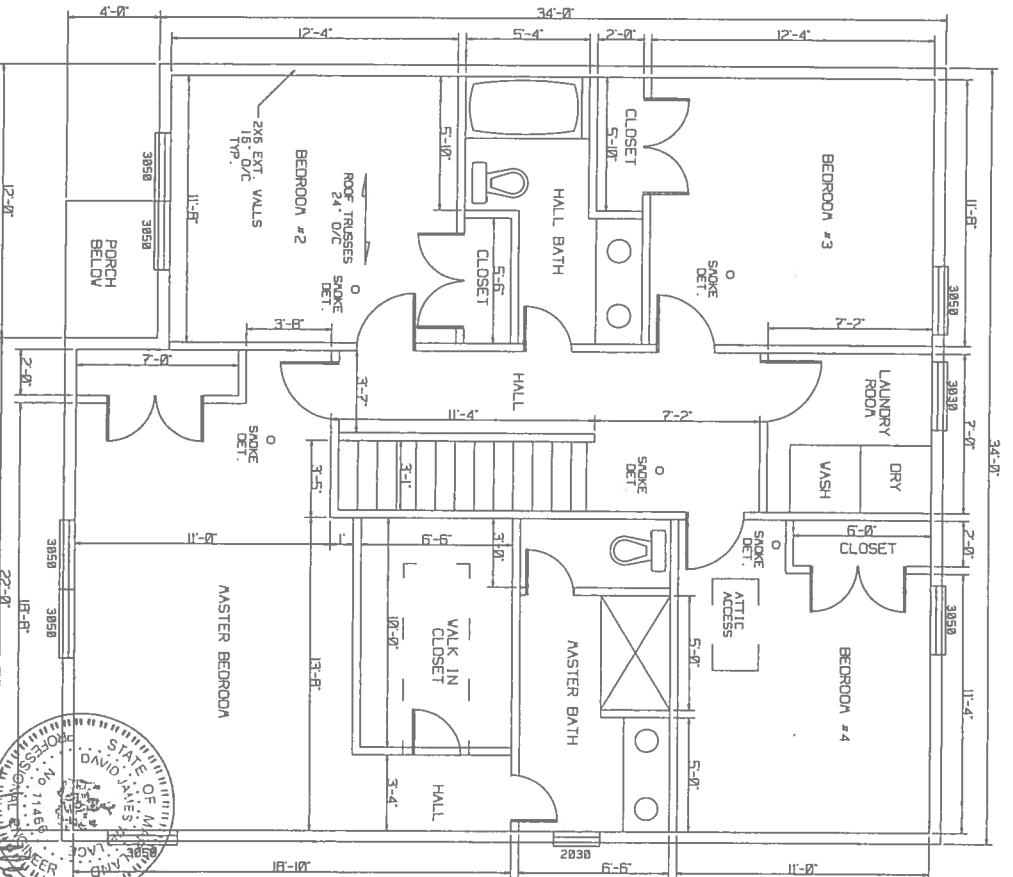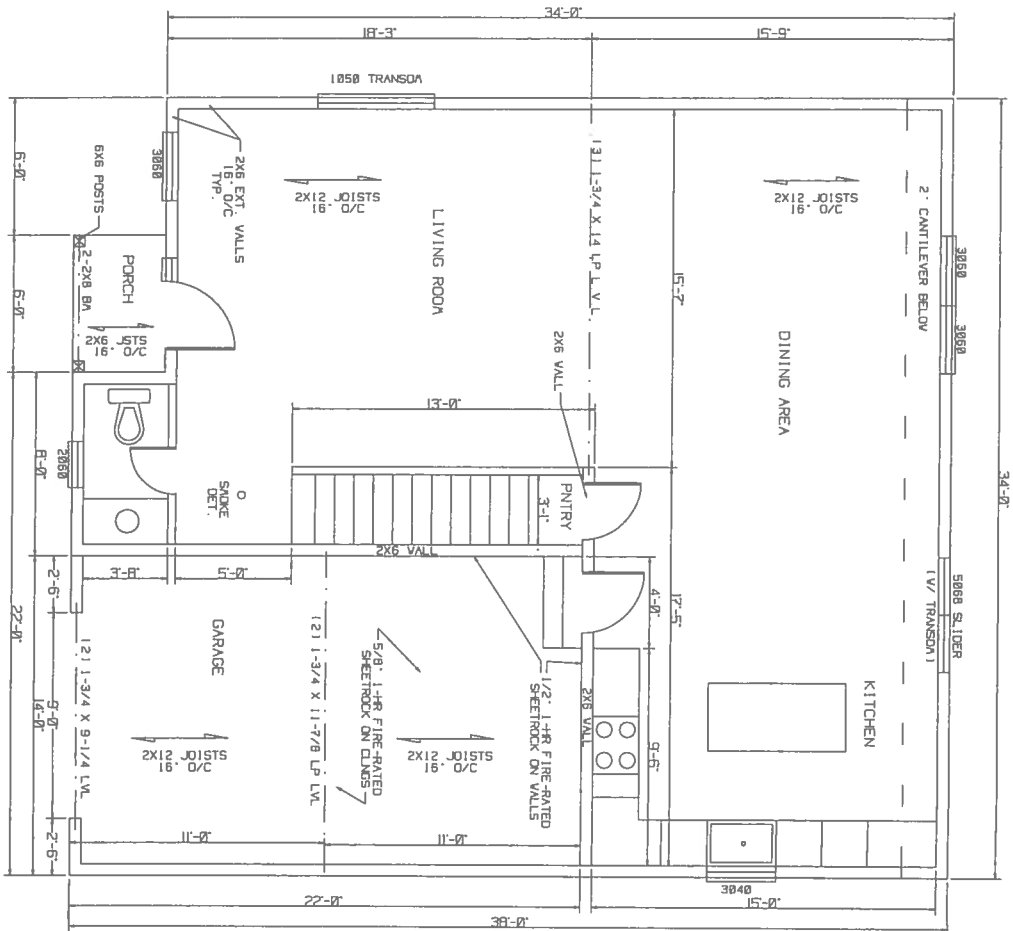

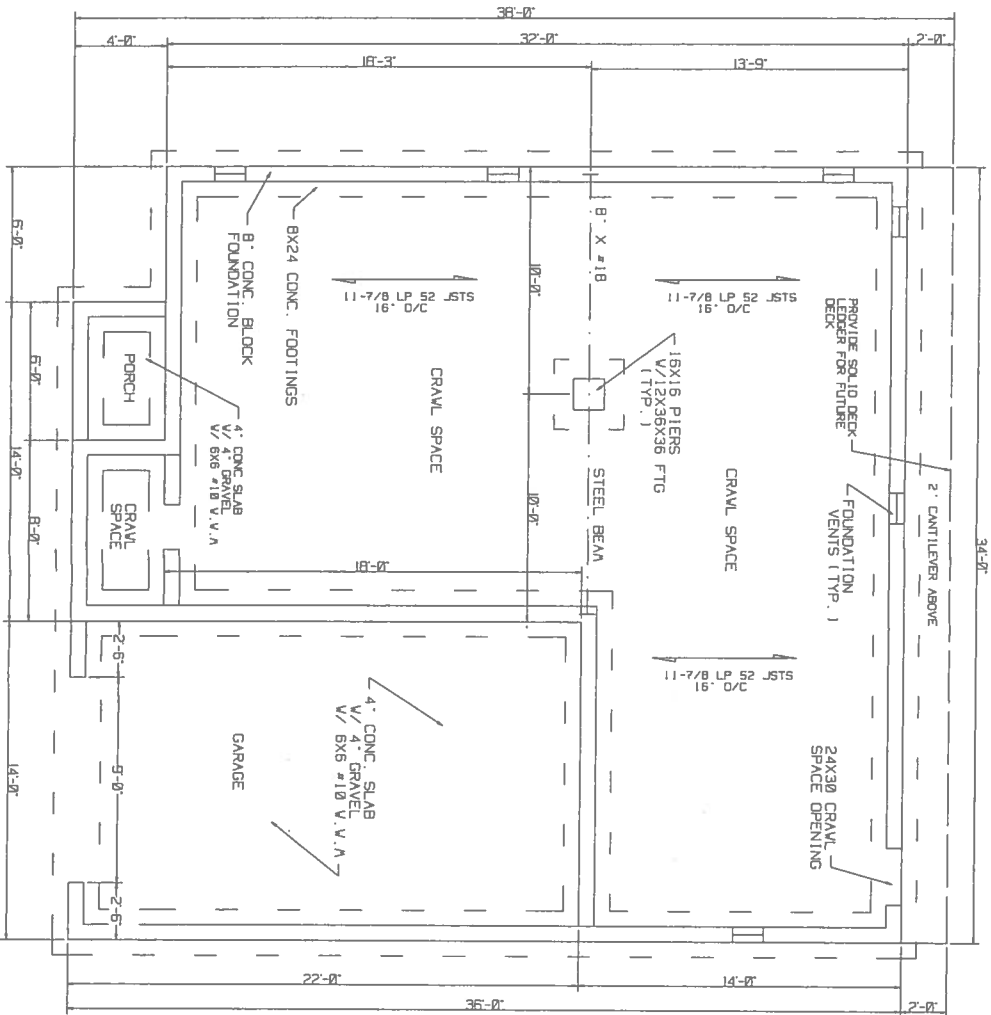

FOUNDATION PLAN
SCALE: 3/16" = 1'

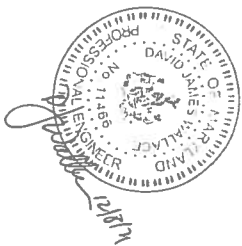

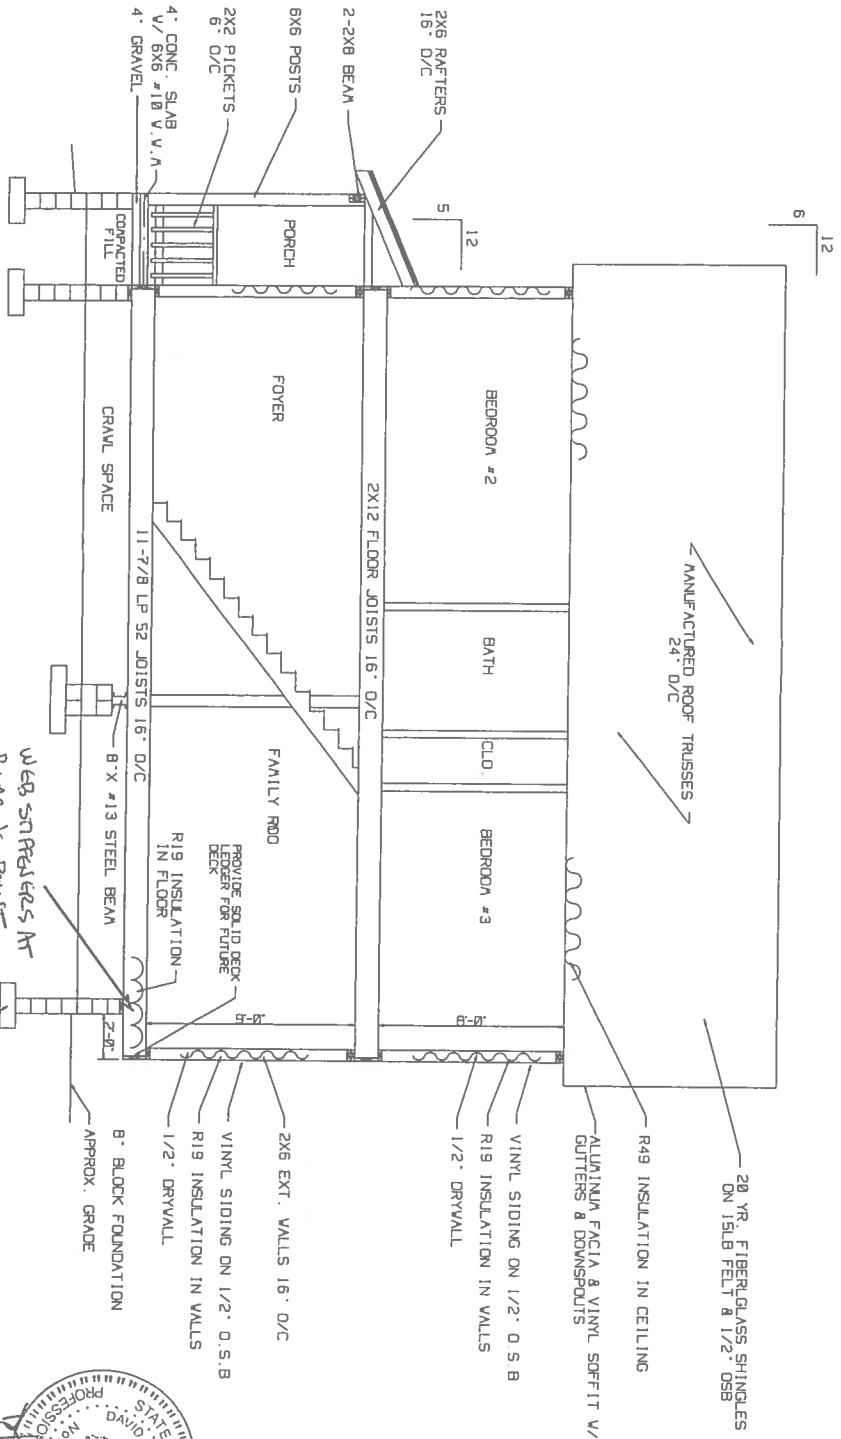

CROSS SECTION VIEW

SCALE: 3/16" = 1'

Professional Certification: I hereby certify that these documents were prepared or approved by me, I am a duly licensed professional engineer under the laws of the State of Maryland, License #11466 Exp. May 20, 2023

